


S=1/150m
出来形分割案

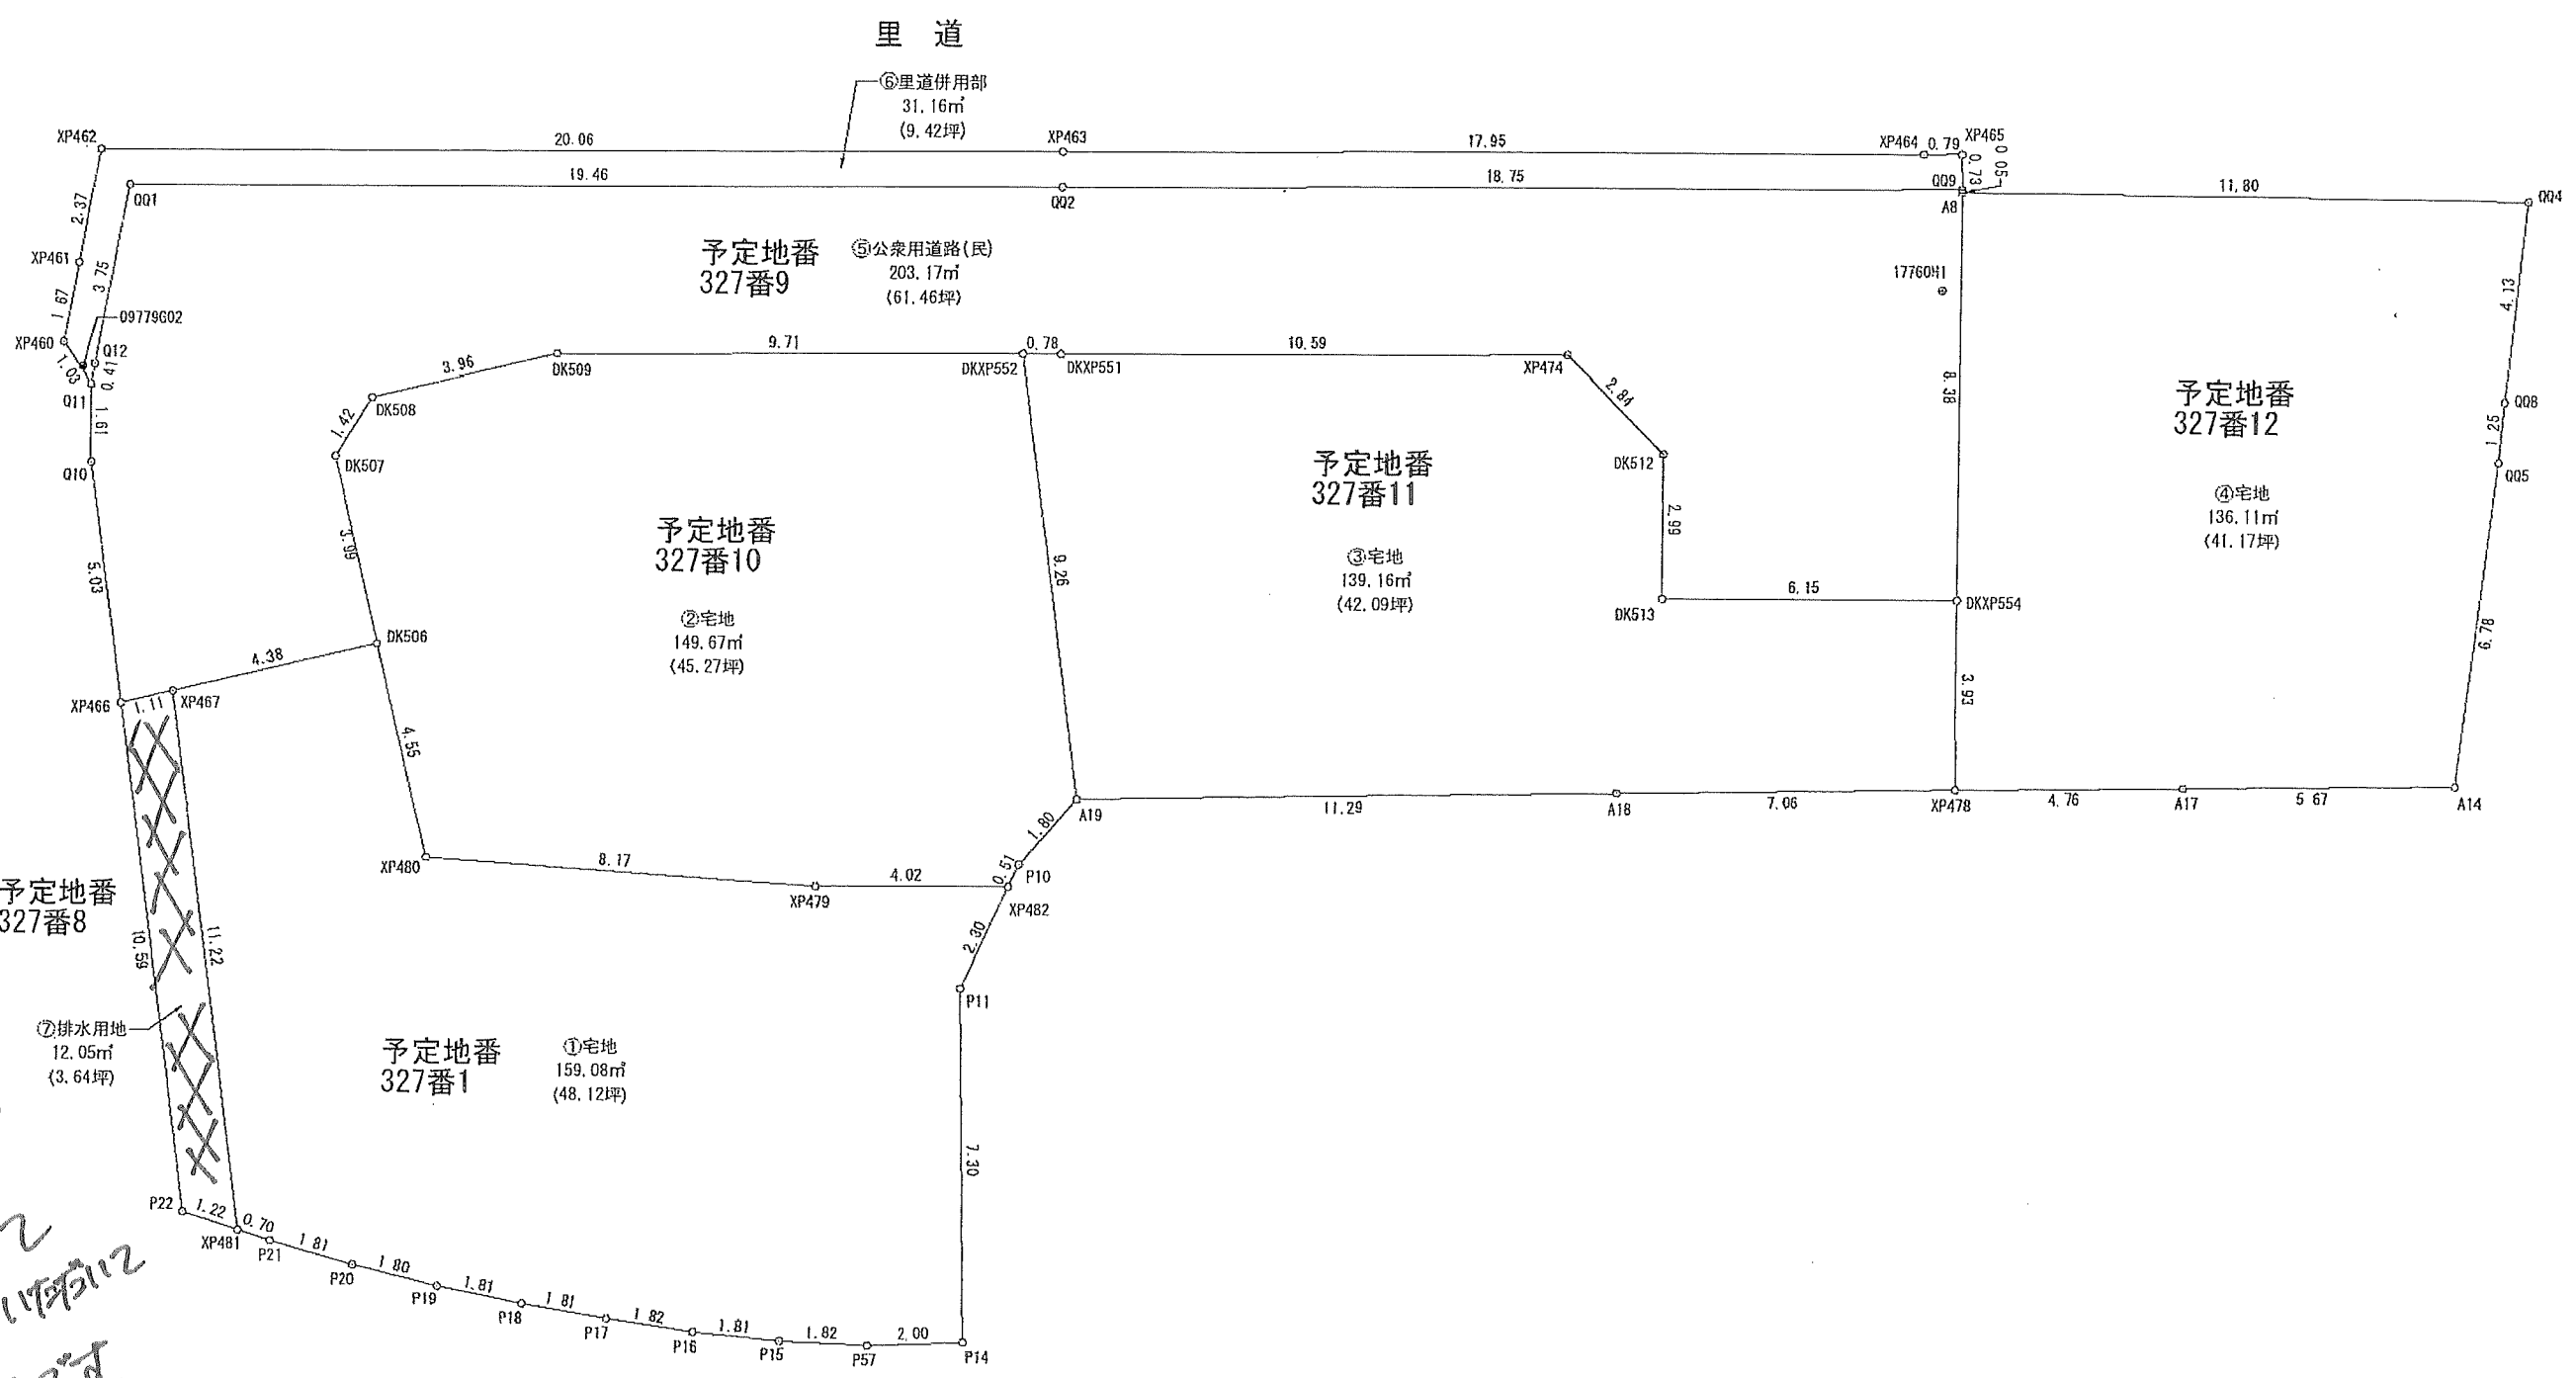

当社の
所有の
土地に就
駐場の
スロースピ
使用に同意
OKです。

基準点座標一覧		
点名	X	Y
09779G02	90994.142	-65107.818
17760H1	90955.495	-65111.618

区画		①宅地		
点名	標識	X	Y	辺長
XP467	()	90993.167	-65114.725	
XP481	()	90993.278	-65125.951	11.22
P21	()	90992.646	-65126.258	0.70
P20	()	90990.989	-65126.993	1.81
P19	()	90989.319	-65127.667	1.80
P18	()	90987.606	-65128.270	1.81
P17	()	90985.880	-65128.823	1.81
P16	()	90984.136	-65129.351	1.82
P15	()	90982.374	-65129.783	1.81
P57	()	90980.581	-65130.128	1.82
P14	()	90978.583	-65130.344	2.00
P11	()	90977.672	-65123.101	7.30
XP482	()	90976.415	-65121.171	2.30
XP479	()	90980.400	-65120.601	4.02
XP480	()	90988.388	-65118.878	8.17
DK506	()	90988.798	-65114.338	4.55
XP467	()	90993.167	-65114.725	4.38
		倍面積	318.179621	
		面積	159.0898105	
		地積	159.08	m ²
		坪数	48.12	坪

予定地番
327番1

区画		②宅地		
点名	標識	X	Y	辺長
DK506	()	90988.798	-65114.338	
XP480	()	90988.388	-65118.878	4.55
XP479	()	90980.400	-65120.601	8.17
XP482	()	90976.415	-65121.171	4.02
P10	()	90976.134	-65120.739	0.51
A19	()	90974.770	-65119.564	1.80
DKXP552	()	90974.659	-65110.295	9.26
DK509	()	90984.273	-65108.921	9.71
DK508	()	90988.224	-65109.271	3.96
DK507	()	90989.139	-65110.361	1.42
DK506	()	90988.798	-65114.338	3.99
		倍面積	299.342446	
		面積	149.6712230	
		地積	149.67	m ²
		坪数	45.27	坪

予定地番
327番10

区画		③宅地		
点名	標識	X	Y	辺長
DKXP552	()	90974.659	-65110.295	
A19	()	90974.770	-65119.564	9.26
A18	()	90963.565	-65120.996	11.29
XP478	()	90956.557	-65121.891	7.06
DKXP554	()	90956.007	-65117.990	3.93
DK513	()	90962.104	-65117.124	6.15
DK512	()	90961.691	-65114.156	2.99
XP474	()	90963.393	-65111.879	2.84
DKXP551	()	90973.881	-65110.407	10.59
DKXP552	()	90974.659	-65110.295	0.78
		倍面積	278.322385	
		面積	139.1611925	
		地積	139.16	m ²
		坪数	42.09	坪

予定地番
327番11

区画		④宅地		
点名	標識	X	Y	辺長
DKXP554	()	90956.007	-65117.990	
XP478	()	90956.557	-65121.891	3.93
A17	()	90951.832	-65122.495	4.76
A14	()	90946.202	-65123.212	5.67
QQ5	()	90944.451	-65116.660	6.78
QQ8	()	90944.157	-65115.445	1.25
QQ4	()	90943.157	-65111.432	4.13
A8	()	90954.835	-65109.684	11.80
DKXP554	()	90956.007	-65117.990	8.38
		倍面積	272.224876	
		面積	136.1124380	
		地積	136.11	m ²
		坪数	41.17	坪

予定地番
327番12

区画		⑤公衆用道路(民)		
点名	標識	X	Y	辺長
XP466	()	90994.273	-65114.822	
XP467	()	90993.167	-65114.725	1.11
DK506	()	90988.798	-65114.338	4.38
DK507	()	90989.139	-65110.361	3.99
DK508	()	90988.224	-65109.271	1.42
DK509	()	90984.273	-65108.921	3.96
DKXP552	()	90974.659	-65110.295	9.71
DKXP551	()	90973.881	-65110.407	0.78
XP474	()	90963.393	-65111.879	10.59
DK512	()	90961.691	-65114.156	2.84
DK513	()	90962.104	-65117.124	2.99
DKXP554	()	90956.007	-65117.990	6.15
A8	()	90954.835	-65109.684	8.38
QQ9	()	90954.827	-65109.625	0.05
QQ2	()	90973.398	-65107.005	18.75
QQ1	()	90992.667	-65104.247	19.46
Q12	()	90993.882	-65107.798	3.75
Q11	()	90994.016	-65108.189	0.41
Q10	()	90994.223	-65109.790	1.61
XP466	()	90994.273	-65114.822	5.03
		倍面積	406.348774	
		面積	203.1743870	
		地積	203.17	m ²
		坪数	61.46	坪

予定地番
327番9

区画		⑥里道併用部		
点名	標識	X	Y	辺長
XP460	()	90994.473	-65107.261	
Q11	()	90994.016	-65108.189	1.03
Q12	()	90993.882	-65107.798	0.41
QQ1	()	90992.667	-65104.247	3.75
QQ2	()	90973.398	-65107.005	19.46
QQ9	()	90954.827	-65109.625	18.75
XP465	()	90954.731	-65108.900	0.73
XP464	()	90955.514	-65108.790	0.79
XP463	()	90973.295	-65106.281	17.95
XP462	()	90993.162	-65103.438	20.06
XP461	()	90993.932	-65105.681	2.37
XP460	()	90994.473	-65107.261	1.67
		倍面積	62.327155	
		面積	31.1635775	
		地積	31.16	m ²
		坪数	9.42	坪

里道

区画		⑦排水用地		
点名	標識	X	Y	辺長
XP466	()	90994.273	-65114.822	
P22	()	90994.378	-65125.417	10.59
XP481	()	90993.278	-65125.951	1.22
XP467	()	90993.167	-65114.725	11.22
XP466	()	90994.273	-65114.822	1.11
		倍面積	24.115759	
		面積	12.0578795	
		地積	12.05	m ²
		坪数	3.64	坪

予定地番
327番8